LABOR AND MATERIALS

1	Copper ~~Lead~~ Connection 3/4		$ 2.94
1	Curb { Clock ~~Valve~~ T. S. & V. } 3/4 in.		$ 3.71
1	Service box Old returned { Short 3½X4½ Long 4½X5½ Buff or Rdway }		$ 5.90
27 ~~25~~	Ft. 3/4 in. { Copper Galv. Iron Cast Iron } Pipe at 30		$ 7.50
	Nipples in. at		$
	Bushings to in. at		$
1	~~Red'g~~ ~~Inc'g~~ Couplings 3/4" cop to cop in. at		$
	Union in. at		$
	Meter in. at		$
	Lead Joints at		$
	Compound Joints at		$
3	Hrs. ~~Foreman at~~ WMM-1	1.01	$ 3.03
16	Hrs. ~~Chauffeur~~ at WMM-2	.91	$ 14.56
	Hrs. Tapper at		$
13	Hrs. Labor at	.80	$ 10.40
	Hrs. Labor at		$
2	Hrs. Compressor at	1.20	$ 2.40
	Compensation Ins.		$ .62
	Trucking		$ 1.—
	Builders Use of Water Patch		$ 8.00
	Tap by Weersinster		$
			$
			$
			$
			$ 60.06

27.98

12

Nelson St. ~~Pl.~~ ~~Ave.~~ No. 20

Name of Owner

Lyle

Labor and Mat'l. Report Apr. 8 1948

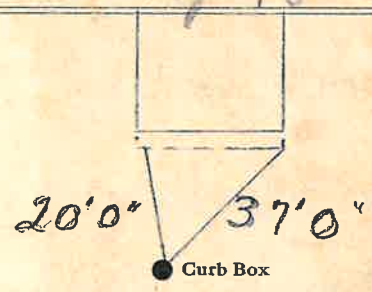

~~4~~ 6" Main

Elev. of Main at tap 6

Gate at ● ● Gate at

● Curb Box

Tax ID # 302.20-10-6

LSM-5C-6-1-45