Labor and Materials

1	Copper ~~Lead~~ Connection	3/4	$ 1.46
1	~~Curb~~ Cock ~~Valve~~ ~~T. S. & V.~~ in	3/4	$ 1.93
1	Service Box Old returned ~~Short 3½ x 4½~~ Long 4½ x 5½ ~~Buff. or Rdway~~		$ 1.77
11	Ft. in. Copper ~~Galv. Iron~~ ~~Cast Iron~~ Pipe at	3/4	$ 2.42
	Nipples in. at		$
	Bushings to in. at		$
	Red'g Inc'g Conplings to in. at		$
	Union in. at		$
	Meter in. at		$
	Lead Joints at		$
	Leadite Joints at		$
	Hrs. Foreman at		$
2	Hrs. Chauffeur at 6.2½		$ 1.25
4	Hrs. Tapper at 6.2½		$ 2.50
4	Hrs. Labor at .45		$ 1.80
	Hrs. Labor at		$
	Hrs. Compressor at		$
	Compensation Ins.		$ 17
	Trucking		$ 1.00
	Builders Use of Water Patch -		$ 5.00
			$
			$
			$
	Tap by Hemel		$
			$ 19.30

103-1937

New St. Pl. Ave. No. 2

Name of Owner

Sawyer

Labor and Mat'l. Report Oct 7 1937

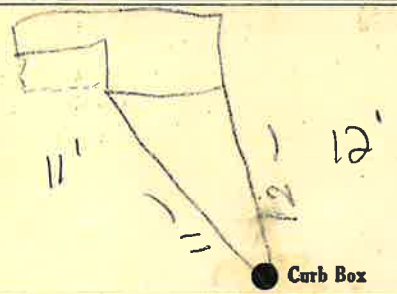

4 Main

Elev. of Main at tap 5

Gate at

Gate at

Curb Box

Old tap shut off

11

Tax ID# 309.12-1-2