LABOR AND MATERIALS

Copper / Lead } Connection _____ $_____

Curb { Cock / Valve / T. S. & V. } _____ in. _____ $_____

Service box / Old returned { Short 3½ x 4½ / Long 4½ x 5½ } _____ $_____

26 Ft. 3/4 in. { Copper / ~~G. I.~~ / ~~C. I.~~ } Pipe at _____ $_____

_____ Nipples _____ in. at _____ $_____

_____ Bushings _____ to _____ in. at _____ $_____

Red'g / Inc'g } Coupl'gs _____ to _____ in. at _____ $_____

_____ Union _____ in. at _____ $_____

_____ Meter _____ in. at _____ $_____

_____ _____ $_____

_____ Compound Joints at _____ $_____

_____ Maintenance Foreman _____ $_____

_____ Hrs. Water Maint. Man—1 at _____ $_____

_____ Hrs. Water Maint. Man—2 at _____ $_____

_____ Hrs. Garage Foreman _____ at _____ $_____

_____ Hrs. Labor— _____ at _____ $_____

_____ Hrs. Compressor at _____ $_____

_____ $_____

_____ Trucking _____ $_____

_____ Pav't Patch _____ $_____

_____ $_____

_____ $_____

_____ $_____

_____ _____ $_____

$_____

NEW St. / ~~Pl.~~ / ~~Ave.~~ No. 21

Name of Owner

Labor and Mat'l. Report 19 75

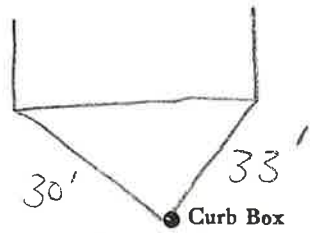

_____ Main Elev. of Main at tap _____

Gate at ● ● Gate at

_____ _____

● Curb Box

Tax ID # 309.35-4-19

LSM—5C—6-1-67