LABOR AND MATERIALS

1	Copper / ~~Lead~~ Connection 3/4	$
1	Curb — Cock / ~~Valve~~ / ~~T. S. & V.~~ — 3/4 in.	$
1	Service box — ~~Short 3½ x 4½~~ / Long 4½ x 5½ / ~~Buff or Rdway~~	$
26 Ft. 1/4 in.	Copper / G. I. / C. I. Pipe at	$
	Nipples in. at	$
	Bushings to in. at	$
	Red'g / Inc'g Coupl'gs to in. at	$
	Union in. at	$
	Meter in. at	$
	Lead Joints at	$
	Compound Joints at	$
	Maintenance Foreman	$
	Hrs. Water Maint. Man—1 at	$
	Hrs. Water Maint. Man—2 at	$
	Hrs. Garage Foreman at	$
	Hrs. Labor— at	$
	Hrs. Compressor at	$
	Compensation Ins. at $ per C	$
	Trucking	$
	Pav't Patch	$
		$
	Tap Aug 2, 1978	$
	By Hermance + Co.	$
	O'head	$
		$

New St. / ~~Pl.~~ / ~~Ave.~~ No. 23

Name of Owner

Timothy Phillips

Labor and Mat'l. Report Aug 2, 1978

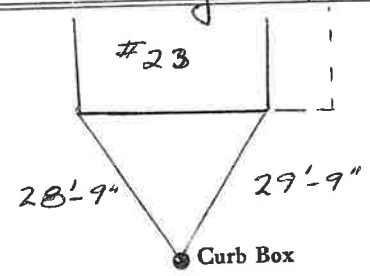

4 Main — Elev. of Main at tap 5'

Gate at • — • Gate at

• Curb Box

Tax ID# 309.35-4-18

LSM—5C—6-1-67