LABOR AND MATERIALS

Copper / Lead } Connection ..... $.....

Curb { Clock / Valve / T. S. & V. } ..... in. ..... $.....

Service box / Old returned { Short 3½X4½ / Long 4½X5⅝ / Buff or Rdway } ..... $.....

..... Ft. ..... in. { Copper / Galv. Iron / Cast Iron } Pipe at ..... $.....

..... Nipples ..... in. at ..... $.....

..... Bushings ..... to ..... in. at ..... $.....

Red'g / Inc'g } Couplings ..... to ..... in. at ..... $.....

..... Union ..... in. at ..... $.....

..... Meter ..... in. at ..... $.....

..... Lead Joints at ..... $.....

..... Compound Joints at ..... $.....

..... Hrs. Foreman at ..... $.....

..... Hrs. Chauffeur at ..... $.....

..... Hrs. Tapper at ..... $.....

..... Hrs. Labor at ..... $.....

..... Hrs. Labor at ..... $.....

..... Hrs. Compressor at ..... $.....

..... Compensation Ins. ..... $.....

..... Trucking ..... $.....

..... Builders Use of Water ..... $.....

Measured by Marsinske Car ..... $.....

..... $.....

..... $.....

..... $.....

..... $.....

New ..... St. / ~~Pl.~~ / ~~Ave.~~ No. 35

Name of Owner

Labor and Mat'l. Report June 1945

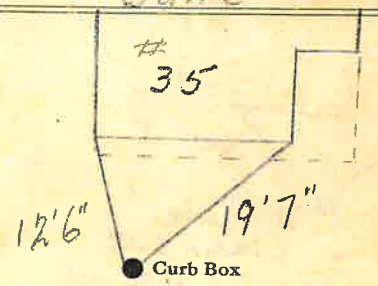

..... Main

Elev. of Main at tap .....

Gate at ●

● **Gate at**

● **Curb Box**

TAX ID # 309.7-14-12

LSM-SC-6-1-45

LABOR AND MATERIALS

1	Copper ~~Lead~~ Connection 3/4	$ 1.35
1	Curb {Cock ~~Valve~~ ~~T. S. & V.~~} {3/4} in.	$ 1.80
1	Service Box Old returned {Short 3⅛x4⅛ ~~Long 4⅛x5⅛~~ ~~Buff or Rdway~~}	$ 1.70
11	Ft. 3/4 in. {Copper ~~Galv Iron~~ ~~Cast Iron~~} Pipe at 18	$ 1.98
	Nipples ... in. at ...	$
	Bushings ... to ... in. at ...	$
	Red'g Inc'g Couplings ... to ... in. at ...	$
	Union ... in. at ...	$
	Meter ... in. at ...	$
	Lead Joints at ...	$
	Leadite Joints at ...	$
	Hrs. Foreman at ...	$
	Hrs. Chauffeur at ...	$
	Hrs. Tapper at ...	$
7	Hrs. Labor at .45	$ 3.15
	Hrs. Labor at ...	$
	Hrs. Compressor at ...	$
	Compensation Ins.	$ .10
	Trucking	$ 1.—
	Builders Use of Water Patch	$ 5.00
	Tap by Penn	$
		$
		$
		$
		$ 16.08

3 1 1941

St.
Pl.
Ave. No. 35

Name of Owner

Murray

Labor and Mat'l. Report May 22 1941

3 Gal Main

Elev. of Main at tap 47

Gate at ●

● Gate at

● Curb Box