LABOR AND MATERIALS

1	Copper / ~~Lead~~ Connection 3/4	$ 1.23
1	Curb { Cock / ~~Valve~~ / ~~T. S. & V.~~ } 3/4 in.	$ 1.68
1	Service Box Old returned { ~~Short 3½x4½~~ / ~~Long 4½x5½~~ / ~~Buff. or Rdway~~ }	$ 1.54
20 Ft. 3/4 in.	{ Copper / ~~Galv. Iron~~ / ~~Cast Iron~~ } Pipe at 17	$ 3.40
	Nipples ____ in. at	$
	Bushings ____ to ____ in. at	$
	Red'g / Inc'g Couplings ____ to ____ in. at	$
	Union ____ in. at	$
	Meter ____ in. at	$
	Lead Joints at	$
	Leadite Joints at	$
	Hrs. Foreman at	$
9	Hrs. Chauffeur at 62½	$ 5.63
9	Hrs. Tapper at	$ 5.62
1	Hrs. Labor at 45	$ .45
	Hrs. Labor at	$
	Hrs. Compressor at	$
	Compensation Ins.	$ .36
	Trucking	$ 1.00
	Builders Use of Water Patch	$ 5.00
Tap by Hessel		$
		$
		$
		$
		$ 25.91

7 5 - - 1939

St. / ~~Pl~~ Ave. No. 39

New

Name of Owner

Tidison

Labor and Mat'l. Report Sept 14 1939

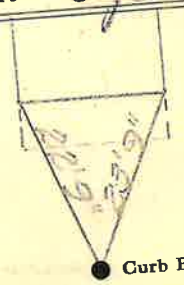

3 Cal Main

Elev. of Main at tap 7

Gate at

Gate at

Curb Box

Tax ID # 309.7-14-10

old Shut off