LABOR AND MATERIALS

1	Copper Lead } Connection		$ 2.80
	Curb { Clock Valve T. S. & V. }	in.	$ 3.60
	Service box Old returned { Short 3½X4½ Long 4½X5½ Buff or Rdway }		$ 5.80
28	Ft. in. { Copper Galv. Iron Cast Iron } Pipe at 35		$ 9.80
	Nipples	in. at	$
	Bushings	to in. at	$
	Red'g Inc'g } Couplings	to in. at	$
	Union	in. at	$
	Meter	in. at	$
	Lead Joints at		$
	Compound Joints at		$
	Hrs. Foreman at		$
	Hrs. Chauffeur at		$
6	Hrs. Tapper at	91	$ 5.46
18	Hrs. Labor at	80	$ 14.40
	Hrs. Labor at		$
	Hrs. Compressor at		$
	Compensation Ins.		$ 1.44
	Trucking		$ 1.10
	Builders Use of Water		$ 9.30
			$
			$
			$
			$
			$ 52.60

123-47

1

St.
~~Pl.~~
~~Ave.~~ No. 5

New

Name of Owner

Everetts

Labor and Mat'l. Report Sept 11 1947

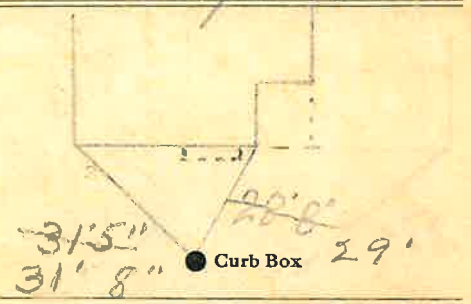

Main

Elev. of Main at tap

Gate at ●

● Gate at

● Curb Box

Tax ID# 309.35-4-26

LSM-5C-6-1-48