LABOR AND MATERIALS

1	Copper ~~Lead~~ Connection	3/4	$ 1.35
1	Curb { Cock ~~Valve~~ ~~T. S. & V.~~ }	3/4 in.	$ 1.88
	Service Box Old returned { Short 3½x4½ Long 4½x5½ Buff. or Rdway }		$ 1.82
26	Ft. 3/4 in. { Copper ~~Galv Iron~~ ~~Cast Iron~~ } Pipe at .20		$ 5.20
	Nipples ____ in. at		$
	Bushings ____ to ____ in. at		$
	Red'g Inc'g } Couplings ____ to ____ in. at		$
	Union ____ in. at		$
	Meter ____ in. at		$
	Lead Joints at		$
	Leadite Joints at		$
	Hrs. Foreman at		$
11	Hrs. Chauffeur at .6814		$ 7.56
	Hrs. Tapper at		$
12	Hrs. Labor at .55		$ 6.60
	Hrs. Labor at		$
	Hrs. Compressor at		$
	Compensation Ins.		$ .43
	Trucking		$ 1.—
	Builders Use of Water Patch		$ 5.00
	Tap by Warsinski		$
			$
			$
			$ 30.84

8 5 1942

Nau St. ~~Pl.~~ Ave. No. 7

Name of Owner

Smith

Labor and Mat'l. Report July 30 1942

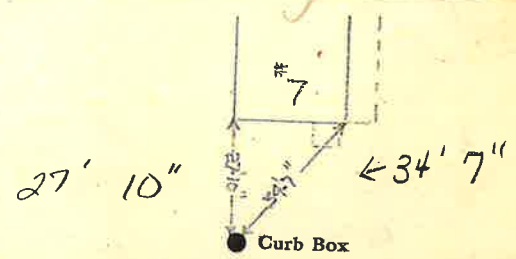

4 Main — Elev. of Main at tap 6

Gate at ● — ● Gate at

● Curb Box

Tax ID # 309.35-4-25