Labor and Materials

1	Lead Connection 3/4	$
1	Curb Cock 1	$
1	Service Box Old returned { [redacted] Long 4½ x 5½ Buffalo	$
24	Ft. 1" in. G. I. Pipe at 1	$
	Nipples in. at	$
	Bushings to in. at	$
	Red'g Coup to in. at	$
	Inc'g Coup to in. at	$
	Union in. at	$
	Meter in. at	$
	Cu. Yds. Br. Stone at	$
	Cu. Yds. Sand at	$
	Bags Cement at	$
	Paving Brick { Mack Red Asphalt } at	$
2	Hrs. Foreman at	$
10	Hrs. Common Labor at	$
	Hrs. Mason at	$
	Hrs. at	$
	Hrs. at	$
900	Builders' Use of Water	$
	at	$
	Truck 100 at	$
	at	$
	at	$
	Total	$ 14.62

Labor and Material Report 19 June 1924

9 New St.

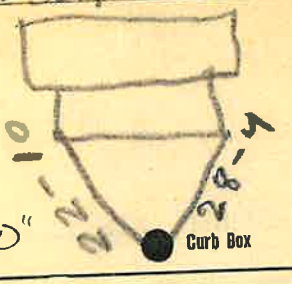

11 Main

Elev. of Main at tap 11½

Gate at ●

● Gate at

● Curb Box

Tax ID # 309.35-4-24