LABOR AND MATERIALS

1	Copper Lead } Connection 3/4	$ 1.35
1	Curb { Cock Valve T. S. & V. } 3/4 in.	$ 1.90
1	Service Box Old returned { Short 3⅛x4⅛ Long 4⅛x5⅛ Buff or Rdway }	$ 1.70
25	Ft. 3/4 in. { Copper Galv Iron Cast Iron } Pipe at 18	$ 4.50
	Nipples in. at	$
	Bushings to in. at	$
	Red'g Inc'g } Couplings to in. at	$
	Union in. at	$
	Meter in. at	$
1	Lead Joints at 3/4 Copper to Iron	$ 0.55
	Leadite Joints at	$
	Hrs. Foreman at	$
2	Hrs. Chauffeur at 62½	$ 1.25
2	Hrs. Tapper at	$ .50
8	Hrs. Labor at 45	$ 3.60
	Hrs. Labor at	$
	Hrs. Compressor at	$
	Compensation Ins.	$ .30
	Trucking	$ 1.—
	Builders Use of Water Patch	$ 5.00
	Tap by Hessel	$
		$
		$
		$
		$ 26.05

3 7 1941

St. Pl. Ave. No. North Delaware 2

Name of Owner

San Souci

Labor and Mat'l. Report June 2, 1941

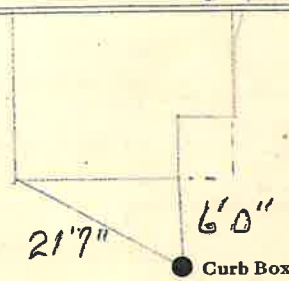

2 Gal Main

Elev. of Main at tap 6

Gate at ●

● Gate at

● Curb Box

TDX ID # 309.27-6-10