LABOR AND MATERIALS

1	Copper ~~Lead~~ } Connection 3/4		$ 1.31
1	Curb { Cock ~~Valve~~ ~~T. S. & V.~~ } 3/4 in.		$ 1.75
1	Service Box Old returned { Short 3½x4½ Long 4½x5½ Buff or Rdway }		$ 1.60
6	Ft. 3/4 in. { Copper Galv Iron Cast Iron } Pipe at 18		$ 1.08
	Nipples ..... in. at		$
	Bushings ..... to ..... in. at		$
	Red'g Inc'g } Couplings ..... to ..... in. at		$
	Union ..... in. at		$
	Meter ..... in. at		$
	Lead Joints at		$
	Leadite Joints at		$
	Hrs. Foreman at		$
	Hrs. Chauffeur at		$
4	Hrs. Tapper at 62½		$ 2.50
3	Hrs. Labor at 45		$ 1.35
	Hrs. Labor at		$
	Hrs. Compressor at		$
	Compensation Ins.		$ .12
	Trucking		$ 1.—
	Builders Use of Water Ext. of main		$ —
	Tap b Hessel		$
			$
			$
			$
			$ 10.71

150 - 1940

37

North Pearl St. ~~Pl.~~ Ave. No. 27

Name of Owner

Carter

Labor and Mat'l. Report Nov 25 1940

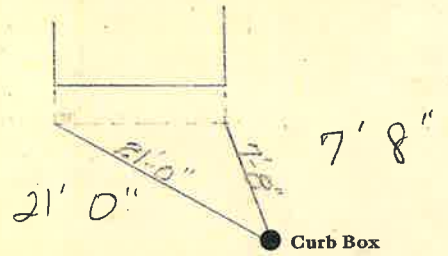

2 Iron Main

Elev. of Main at tap 5

Gate at ● ● Gate at

● Curb Box

Tax ID # 303.17-1-41