LABOR AND MATERIALS

1 Copper / Lead } Connection 3/4" $

1 Curb } Cock / Valve / T. S. & V. } 3/4 in. Oriseal $

1 Service box / Old returned { Short 3½ x 4½ / Long 4½ x 5½ / Buff or Rdway } $

2½ Ft. 3/4 in. { Copper / G. I. / C. I. } Pipe at $

Nipples in. at $

Bushings to in. at $

Red'g / Inc'g } Coupl'gs to in. at $

Union in. at $

Meter in. at $

Lead Joints at $

Compound Joints at $

Maintenance Foreman $

Hrs. Water Maint. Man—1 at $

Hrs. Water Maint. Man—2 at $

Hrs. Garage Foreman at $

Hrs. Labor— at $

Hrs. Compressor at $

Compensation Ins. at $ per C $

Trucking $

Pav't Patch $

$

Tap by Kelly + Co. $

$

O'head 6-[illegible]-65 $

$

St. / Pl. / Ave. No. North Pearl 40

Name of Owner

Kenneth S. Ellsworth

Labor and Mat'l. Report June 1965

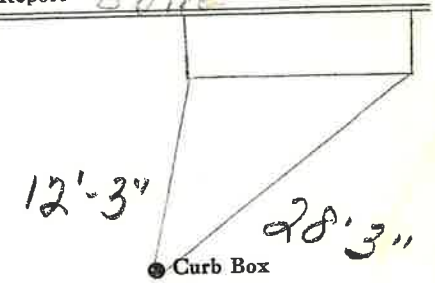

2" C.I. Main

Elev. of Main at tap 15'

Gate at ●

● Gate at

● Curb Box

LSM—5C—3-10-61