Labor and Materials
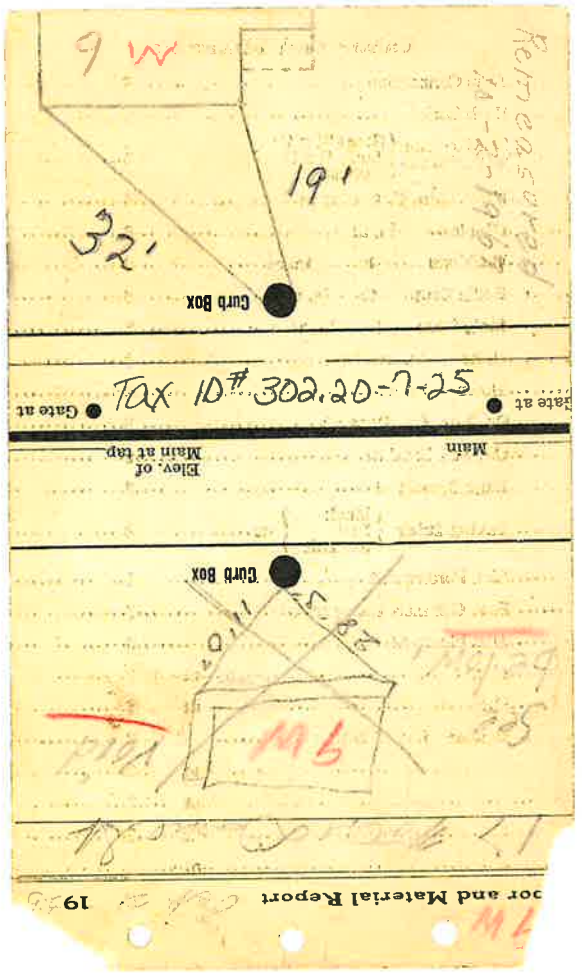
1	~~Lead~~ Connection Brass	$
1	Curb Cock Ord.	$
1	Service Box { Short 3½ x 4½ / ~~Long 4½ x 6½~~ / Buffalo } Old returned	$
29	Ft. ¾ in. ~~Gal.~~ Pipe at	$
	Nipples ..... in. at	$
	Bushings ..... to ..... in. at	$
	Red'g Coup .... to .... in. at	$
	Inc'g Coup .... to .... in. at	$
	Union .... in. at	$
	Meter .... in. at	$
	Cu. Yds. Br. Stone at	$
	Cu. Yds. Sand at	$
	Bags Cement at	$
	Paving Brick { Mack / Red / Asphalt } at	$
8	Hrs. Foreman at	$
26	Hrs. Common Labor at	$
	Hrs. Mason at	$
2	Hrs. Compressor at	$ 3.00
	Hrs. at	$
9	Builders' Use of Water	$
	at	$
Truck	Payment at	$
	at	$
	at	$
	Total	$ 28.81