LABOR AND MATERIALS

1	Copper ~~Lead~~ Connection 3/4		$ 1.79
1	Curb Clock ~~Valve~~ ~~T. S. & V.~~ 3/4 in.		$ 2.61
1	Service box Old returned ~~Short 3½X4½~~ Long 4½X5½ Buff or Rdway		$ 1.82
8	Ft. 3/4 in. Copper ~~Galv. Iron~~ Cast Iron Pipe at 23		$ 1.84
	Nipples in. at		$
	Bushings to in. at		$
	Red'g Inc'g Couplings to in. at		$
	Union in. at		$
	Meter in. at		$
	Lead Joints at		$
	Compound Joints at		$
	Hrs. Foreman at		$
5	Hrs. Chauffeur at	82½	$ 4.13
	Hrs. Tapper at		$
19	Hrs. Labor at	71½	$ 13.58 17.71
	Hrs. Labor at		$
2	Hrs. Compressor at	87½	$ 1.75
	Compensation Ins.		$ .49
	Trucking		$ 1.00
	Builders Use of Water		$ 9.00
	Tap by Warsinski		$
			$
			$
			$
			$ 38.01

72-46

St. ~~Pl.~~ ~~Ave.~~ No. 24 18W-ST

Notre Dame

Name of Owner

Church Messiah

Labor and Mat'l. Report Aug 8 1946

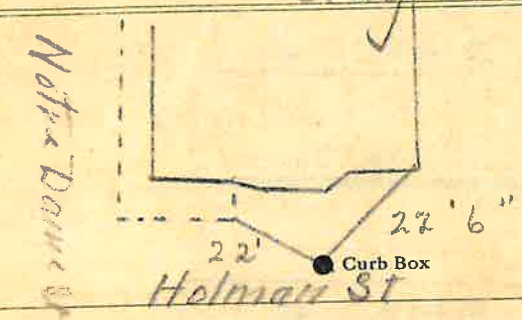

4" Main

Elev. of Main at tap 6'

Gate at ● ● Gate at

Tax ID # 302.20-15-7

● Curb Box

LSM-5C-6-1-45