Labor and Materials

1	Lead Connection 3/4	$
1	Curb Cock 1"	$
1	Service Box Old returned { Short 3½ x 4½ / Long 4½ x 5½ / Buffalo	$
7	Ft. 1" in. G. I. Pipe at	$
	Nipples ..... in. at	$
	Bushings ..... to ..... in. at	$
	Red'g Coup .... to .... in. at	$
	Inc'g Coup .... to .... in. at	$
	Union .... in. at	$
	Meter .... in. at	$
200	Cu. Yds. Br. Stone at	$
200	Cu. Yds. Sand at	$
1	Bags Cement at	$
29	Paving Brick { Mack / Red / Asphalt } at	$
4	Hrs. Foreman at	$
15½	Hrs. Common Labor at	$
2	Hrs. Mason at	$
2	Hrs. at	$
	Hrs. at	$
20	Builders' Use of Water	$
	at	$
	Truck 100 at	$
	Pavement 1/2 27 at	$
	at	$
	Total	$24.80

2 OW

Labor and Material Report Sept 13 19 24

3/4 Tap 26' Notre Dame St

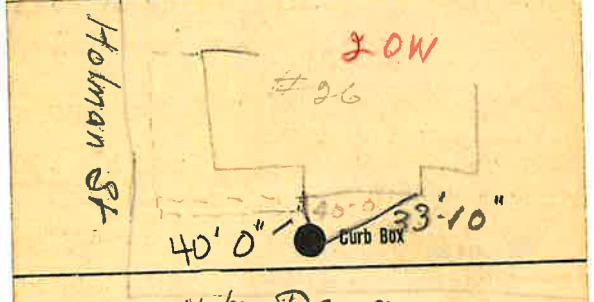

4" Main

Elev. of Main at tap 5

Gate at

Gate at

Curb Box

Pavement