LABOR AND MATERIALS

1	Copper / Lead } Connection 3/4	$ 1.79
1	Curb { Clock / Valve / T. S. & V. } 3/4 in.	$ 2.61
1	Service box / Old returned { Short 3½X4½ / Long 4½X5½ / Buff or Rdway }	$ 1.82
7	Ft. 3/4 in. { Copper / Galv. Iron / Cast Iron } Pipe at 23	$ 1.61
	Nipples in. at	$
	Bushings to in. at	$
	Red'g / Inc'g } Couplings to in. at	$
	Union in. at	$
	Meter in. at	$
	Lead Joints at	$
	Compound Joints at	$
7	Hrs. ~~Foreman at~~ WWM 84	$ 588
	Hrs. Chauffeur at	$
7	Hrs. Tapper at 75	$ 525
	Hrs. Labor at	$
	Hrs. Labor at	$
	Hrs. Compressor at	$
	Compensation Ins.	$ 31
	Trucking	$ 1.00
	Builders Use of Water	$ 9.00
	Tops by Millers & Marquinn	$
		$
		$
		$
		$ 29.27

✓

3-46

St. 28 West
Pl.
Notre Dame Ave. No. ~~32~~

Name of Owner
Carter

Labor and Mat'l. Report Jan 16 1946

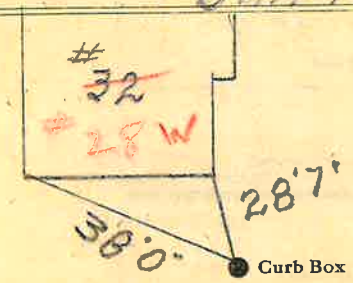

4 Main

Elev. of Main at tap 5

Gate at ● ● Gate at

TAX ID # 302.20-14-7

● Curb Box

LSM-5C-6-1-45