Labor and Materials

1	Copper ~~Lead~~ Connection	3/4	$3.20
1	Curb { Cock ~~Valve~~ ~~T. S. & V.~~ }	3/4 in.	$1.00
1	Service Box { Short 3½ x 4½ ~~Long 4½ x 5½~~ ~~Buff. or Rdway~~ }		$1.30
8	Ft. 3/4 in. { Copper Galv. Iron ~~Cast Iron~~ } Pipe at		$1.76
	Nipples ..... in. at		$
	Bushings ..... to ..... in. at		$
	Red'g Inc'g } Couplings ..... to ..... in. at		$
	Union ..... in. at		$
	Meter ..... in. at		$
	Lbs. Br. Stone at		$
	Lbs. Sand at		$
	Bags Cement at		$
	Paving Brick { Mack Red Asphalt } at		$
	Lead Joints at		$
	Leadite Joints at		$
3	Hrs. Foreman at		$1.88
	Hrs. Common Labor at		$3.66
9	Hrs. Common Labor at ~~40~~		$
	Hrs. Mason at		$
	Hrs Mason's Helper at		$
	Hrs. Compressor at		$
	Compensation Ins.		$ .15
	Trucking		$1.00
	Builders' Use of Water		$
	Total		$13.95

27-231 36W

Labor and Material Report Dec. 1 1927

No 40 Notre Dame ST

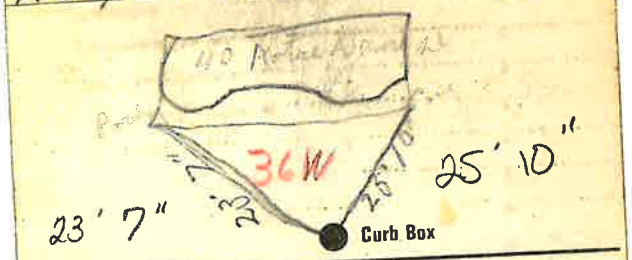

6" Main — Elev. of Main at tap 4ft

Gate at ● — ● Gate at

● Curb Box

Old shut off

Tax ID# 302.20-14-11