LABOR AND MATERIALS

1	Copper ~~Lead~~ Connection 3/4"	$ 1.59
1	Curb { Clock Valve ~~T. S. & V.~~ } 3/4 in.	$ 2.74
1	Service box Old returned { Short 3½X4½ ~~Long 4½X5½~~ Buff or ~~Rdway~~ }	$ 1.82
22 Ft. 3/4 in.	{ Copper Galv. Iron ~~Cast Iron~~ } Pipe at 19	$ 4.18
	Nipples ... in. at ...	$
	Bushings ... to ... in. at ...	$
	Red'g Inc'g Couplings ... to ... in. at ...	$
	Union ... in. at ...	$
	Meter ... in. at ...	$
	Lead Joints at ...	$
	Compound Joints at ...	$
	Hrs. Foreman at ...	$
	Hrs. Chauffeur at ...	$
17	Hrs. Tapper at 75	$ 12.75 N
12	Hrs. Labor at 65	$ 7.80 N
	Hrs. Labor at ...	$
	Hrs. Compressor at ...	$
	Compensation Ins. ...	$ .55
	Trucking ...	$ 1.00
2	Builders Use of Water ...	$ 9.00
Tap by Maguire		$
		$
		$
		$
		$ 41.43

Patch?

27-45

St. 62 West
Pl.
Notre Dame Ave. No. 19

Name of Owner

Boyce

Labor and Mat'l. Report Sept 19 1945

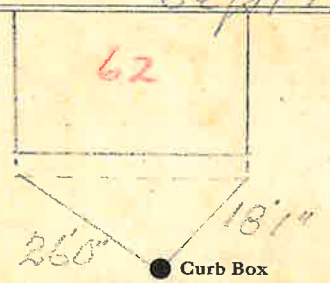

6" Main

Elev. of Main at tap 5'

Gate at ● ● Gate at

● Curb Box

Tax ID # 302.19-28-9

LSM-5C-6-1-45