LABOR AND MATERIALS

1	Copper / ~~Lead~~ Connection	3/4	$ 1.35
1	Curb { Cock / Valve / T. S. & V. }	3/4 in.	$ 1.80
	Service Box Old returned { Short 3⅛x4⅛ / Long 4⅛x5⅛ / Buff or Rdway }	Same	$ —
8	Ft. 3/4 in. { Copper / Galv Iron / Cast Iron } Pipe at		$ 1.44
	Nipples in. at		$
	Bushings to in. at		$
	Red'g / Inc'g } Couplings to in. at		$
	Union in. at		$
	Meter in. at		$
	Lead Joints at		$
	Leadite Joints at		$
	Hrs. Foreman at		$
1	Hrs. Chauffeur at	4.38	$ 4.38
1¼	Hrs. Tapper at	3.26	$ 4.07
9¼	Hrs. Labor at	45	$ 4.27
	Hrs. Labor at		$
1¼	Hrs. Compressor at	.94	$ .94
	Compensation Ins.	.39	$ .39
	Trucking	1 —	$ 1 —
	Builders Use of Water	Patch	$ 9 —
	Tap by Hesse		$
			$
			$
			$
			$ 28 64

1 1 8 1941

St. 71 W

Pl.

Ave. No. 13

Notre Dame

Name of Owner

[illegible]

Labor and Mat'l. Report Sept 30 19 41

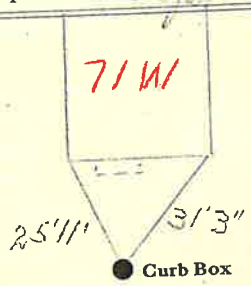

6 Main

Elev. of Main at tap 5½

Gate at

Gate at

Curb Box