Labor and Materials

Copper / Lead	Connection	$
Curb	Cock / Valve / T. S. & V. ... in	$
Service Box / Old returned	Short 3½ x 4½ / Long 4½ x 5½ / Buff. or Rdway	$
Ft. ... in.	Copper / Galv Iron / Cast Iron — Pipe at	$
Nipples	in. at	$
Bushings	to ... in. at	$
Red'g / Inc'g	Couplings ... to ... in. at	$
Union	in. at	$
Meter	in. at	$
Lead Joints at		$
Leadite Joints at		$
Hrs. Foreman at		$
Hrs, Chauffeur at		$
Hrs. Tapper at		$
Hrs. Labor at		$
Hrs. Labor at		$
Hrs. Compressor at		$
Compensation Ins.		$
Trucking		$
Builders Use of Water		$
		$
		$
		$
		$
		$

Notre Dame St. ~~Pl.~~ Ave. No. 75 73W

Name of Owner

Tax ID# 302.19-25-18

Labor and Mat'l. Report 19

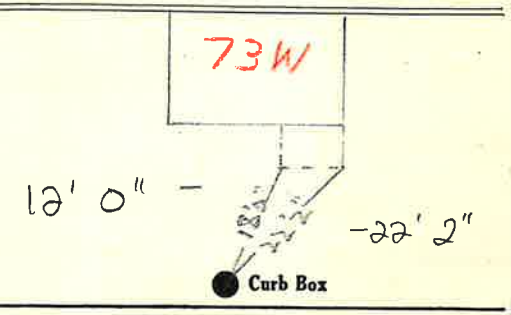

6 Main

Elev. of Main at tap 5

Gate at

Gate at

Curb Box