LABOR AND MATERIALS

1 Copper ~~Lead~~	Connection 3/4	$ 1.35
1 Curb { ~~Cock~~ Valve ~~T. S. & V.~~ }	3/4 in.	$ 1.80
1 Service Box Old returned	{ Short 3½x4½ Long 4½x5½ Buff or Rdway }	$ 1.70
23 Ft. 3/4 in.	{ Copper ~~Galv Iron~~ Cast Iron } Pipe at 18	$ 4.14
Nipples in. at		$
Bushings to in. at		$
Red'g Inc'g Couplings to in. at		$
Union in. at		$
Meter in. at		$
Lead Joints at		$
Leadite Joints at		$
Hrs. Foreman at		$
4 Hrs. Chauffeur at 62½		$ 2.50
Hrs. Tapper at		$
20 Hrs. Labor at 45		$ 9.00
Hrs. Labor at		$
Hrs. Compressor at		$
Compensation Ins.		$ 35
Trucking		$ 1—
Builders Use of Water Patch		$ 5.00
Tap by Power		$
		$
		$
		$
		$ 26.84

~~8~~ 7 1941

St.
~~Pl.~~
Ave. No. 1

Oak

Name of Owner

Copeland

Labor and Mat'l. Report May 13 1941

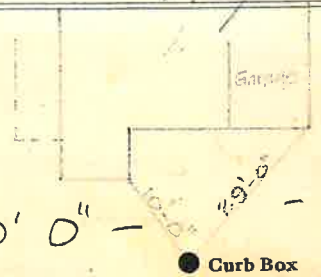

6" Main

Elev. of Main at tap

Gate at ● ● Gate at

Tax ID # 303.17-24.8

● Curb Box