## LABOR AND MATERIALS

| | | | |
|---|---|---|---|
| 1 | Copper Lead } Connection | 3/4 | $ 1.35 |
| 1 | Curb { Cock Valve T. S. & V. } | 3/4 in. | $ 1.80 |
| 1 | Service Box Old returned { Short 3⅛x4⅛ Long 4⅛x5⅛ Buff or Rdway } | | $ 1.70 |
| 14 Ft. | 3/4 in. { Copper Galv Iron Cast Iron } Pipe at | 18 | $ 2.52 |
| | Nipples ..... in. at | | $ |
| | Bushings ..... to ..... in. at | | $ |
| | Red'g Inc'g } Couplings ..... to ..... in. at | | $ |
| | Union ..... in. at | | $ |
| | Meter ..... in. at | | $ |
| | Lead Joints at | | $ |
| | Leadite Joints at | | $ |
| | Hrs. Foreman at | | $ |
| 1 | Hrs. Chauffeur at | 62½ | $ .63 |
| 2 | Hrs. Tapper at | 4 | $ 1.25 |
| 10 | Hrs. Labor at | 45 | $ 4.50 |
| | Hrs. Labor at | | $ |
| | Hrs. Compressor at | | $ |
| | Compensation Ins. | | $ .20 |
| | Trucking | | $ 1.— |
| | Builders Use of Water Ralph Sawin | | $ — |
| | Tap by Hesse | | $ |
| | | | $ |
| | | | $ |
| | | | $ |
| | | | $ 14.95 |

5 4 1941

St. 15
Pl.
Ave. No. 15

Name of Owner

Labor and Mat'l. Report May 20 19 41

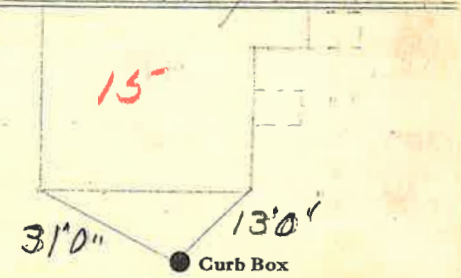


4 Main

Elev. of Main at tap 5

Gate at ● ● Gate at

● Curb Box

TAX ID # 302.16-5-24