LABOR AND MATERIALS

1	Copper Lead — Connection	3/4	$ 1.23
1	Curb — Cock / ~~Valve~~ / ~~T. S. & V.~~	3/4 in.	$ 1.68
1	Service Box Old returned — ~~Short 3½x4½~~ / Long 4½x5½ / ~~Buff. or Rdway~~		$ 1.54
12 Ft.	3/4 in. — Copper / ~~Galv. Iron~~ / ~~Cast Iron~~ Pipe at 17		$ 2.04
	Nipples ____ in. at		$
	Bushings ____ to ____ in. at		$
	Red'g / Inc'g Couplings ____ to ____ in. at		$
	Union ____ in. at		$
	Meter ____ in. at		$
	Lead Joints at		$
	Leadite Joints at		$
	Hrs. Foreman at		$
2	Hrs. Chauffeur at 62½		$ 1.25
6	Hrs. Tapper at		$ 3.75
6	Hrs. Labor at 45		$ 2.70
	Hrs. Labor at		$
	Hrs. Compressor at		$
	Compensation Ins.		$ .24
	Trucking		$ 1.—
	Builders Use of Water Patch		$ .5—
Tapby Hencl			$
			$
			$
			$
			$ 20.43

E 1 - 1939

St. 21
~~Pl.~~
Ogden Ave. No. 19

Name of Owner
Dick Lawless

Labor and Mat'l. Report Cmg 2 1939

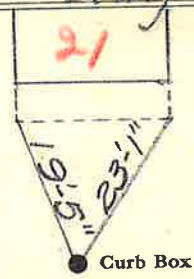

4" Main

Elev. of Main at tap 5½'

Gate at ● ● Gate at

● Curb Box

Tax ID# 302.16-5-21

TK

O/N Shut off