LABOR AND MATERIALS

1	Copper Lead } Connection 3/4	$ 1.35
1	Curb { Cock Valve T. S. & V. } { 3/4 in.	$ 1.80
1	Service Box Old returned { Short 3⅛x4⅛ Long 4⅛x5⅛ Buff or Rdway }	$ 1.70
23 Ft. 3/4	in. { Copper Galv Iron Cast Iron } Pipe at 18	$ 4.14
	Nipples ..... in. at	$
	Bushings ..... to ..... in. at	$
	Red'g Inc'g } Couplings ..... to ..... in. at	$
	Union ..... in. at	$
	Meter ..... in. at	$
	Lead Joints at	$
	Leadite Joints at	$
	Hrs. Foreman at	$
1½	Hrs. Chauffeur at 62½	$ .94
3	Hrs. Tapper at "	$ 1.88
19	Hrs. Labor at 45	$ 8.55
	Hrs. Labor at	$
	Hrs. Compressor at	$
	Compensation Ins.	$ .35
	Trucking	$ 1.—
	Builders Use of Water Tapping Horse / Refuse Pavings	$ —
		$
		$
		$
		$
		$ 21.71

5 8 1941

St. 22
Pl.
Ave. No. 30

Adgen

Name of Owner

First Methodist Parsonage

Labor and Mat'l. Report May 2 1941

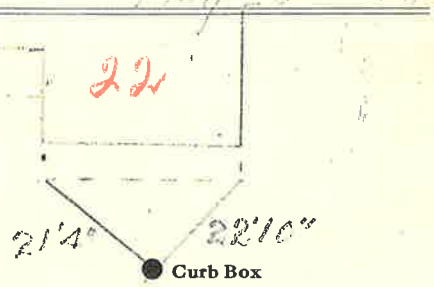

4 Main

Elev. of Main at tap 5—

Gate at ● ● Gate at

● Curb Box

Tax ID# 302.16-4-10