## LABOR AND MATERIALS

| | | |
|---|---|---|
| 1 | Copper / Lead Connection 3/4 | $ 1.35 |
| 1 | Curb { Cock / Valve / T. S. & V. } 3/4 in. | $ 1.80 |
| 1 | Service Box Old returned { Short 3½x4½ / Long 4½x5½ / Buff or Rdway } | $ 1.70 |
| 13 | Ft. 3/4 in. { Copper / Galv Iron / Cast Iron } Pipe at 18 | $ 2.34 |
| | Nipples ..... in. at | $ |
| | Bushings ..... to ..... in. at | $ |
| | Red'g / Inc'g } Couplings ..... to ..... in. at | $ |
| | Union ..... in. at | $ |
| | Meter ..... in. at | $ |
| | Lead Joints at | $ |
| | Leadite Joints at | $ |
| | Hrs. Foreman at | $ |
| 1 | Hrs. Chauffeur at 62½ | $ 63 |
| 2 | Hrs. Tapper at | $ 1.25 |
| 10 | Hrs. Labor at 45 | $ 4.50 |
| | Hrs. Labor at | $ |
| | Hrs. Compressor at | $ |
| | Compensation Ins. | $ 20 |
| | Trucking | $ 1.— |
| | Builders Use of Water Before Boring | $ — |
| | Tap by Hassel | $ |
| | | $ |
| | | $ |
| | | $ |
| | | $ 14.77 |

6 1 1941

St. 25
Pl.
Ave. No.

Name of Owner

L F LaRose

Labor and Mat'l. Report 19

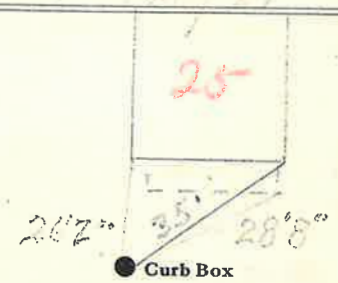


4 Main

Elev. of Main at tap

Gate at

Gate at

Curb Box