LABOR AND MATERIALS

1	Copper Lead } Connection 3/4	$ 1.35
1	Curb { Cock Valve T. S. & V. } 3/4 in.	$ 1.80
1	Service Box Old returned { Short 3½x4½ Long 4½x5½ Buff or Rdway }	$ 1.70
13	Ft. 3/4 in. { Copper Galv Iron Cast Iron } Pipe at 18	$ 2.34
	Nipples in. at	$
	Bushings to in. at	$
	Red'g Inc'g } Couplings to in. at	$
	Union in. at	$
	Meter in. at	$
	Lead Joints at	$
	Leadite Joints at	$
	Hrs. Foreman at	$
1	Hrs. Chauffeur at 62½	$ .63
2	Hrs. Tapper at 45	$ 1.25
10	Hrs. Labor at 45	$ 4.50
	Hrs. Labor at	$
	Hrs. Compressor at	$
	Compensation Ins.	$ .20
	Trucking	$ 1.—
	Builders Use of Water Before Paving	$
	Tayly Hessel	$
		$
		$
		$
		$ 14.77

6 4 1941

St. 29
Pl.
Ave. No. 21

Name of Owner

Mrs Elmer Cochlin

Labor and Mat'l. Report May 13 19 41

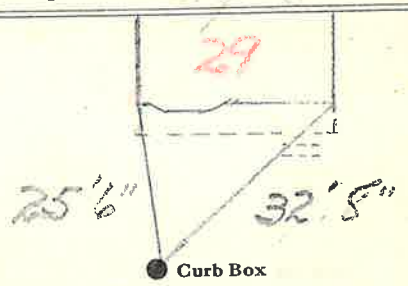

1" Main

Elev. of Main at tap 5'

Gate at

Gate at

Curb Box

Tax ID# 302.16-5-17