LABOR AND MATERIALS

1	Copper / ~~Lead~~ Connection 3/4	$ 1.35
1	Curb { ~~Cock~~ / ~~Valve~~ / ~~T. S. & V.~~ } 3/4 in.	$ 1.80
1	Service Box Old returned { ~~Short 3½x4⅛~~ / ~~Long 4½x5⅛~~ / ~~Buff or Rdway~~ }	$ 1.70
23 Ft. 3/4 in.	{ ~~Copper~~ / ~~Galv Iron~~ / ~~Cast Iron~~ } Pipe at 18	$ 4.14
	Nipples ... in. at	$
	Bushings ... to ... in. at	$
	Red'g / Inc'g Couplings ... to ... in. at	$
	Union ... in. at	$
	Meter ... in. at	$
	Lead Joints at	$
	Leadite Joints at	$
	Hrs. Foreman at	$
1½	Hrs. Chauffeur at 62½	$ .94
3	Hrs. Tapper at "	$ 1.88
19	Hrs. Labor at 45	$ 8.55
	Hrs. Labor at	$
	Hrs. Compressor at	$
	Compensation Ins.	$ .35
	Trucking	$ 1.00
	Builders Use of Water Before Paving	$ —
	Tap by Horse	$
		$
		$
		$
		$ 21.71

6 5 1941

St. 32
~~Pl.~~
~~Ave.~~ No. 30

Odgen

Name of Owner

Lester Coltower

Labor and Mat'l. Report May 23 19 41

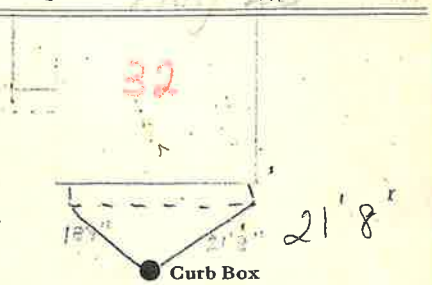

Main

Elev. of Main at tap

Gate at

Gate at

Tax ID # 302.16-1-12

Curb Box