LABOR AND MATERIALS

1	Copper / Lead } Connection 3/4		$ 1.35
1	Curb { Cock / Valve / T. S. & V. } 3/4 in.		$ 1.80
1	Service Box / Old returned { Short 3½x4½ / Long 4½x5½ / Buff or Rdway }		$ 1.70
23	Ft. 3/4 in. { Copper / Galv Iron / Cast Iron } Pipe at 18		$ 4.14
	Nipples ... in. at		$
	Bushings ... to ... in. at		$
	Red'g / Inc'g } Couplings ... to ... in. at		$
	Union ... in. at		$
	Meter ... in. at		$
	Lead Joints at		$
	Leadite Joints at		$
	Hrs. Foreman at		$
1½	Hrs. Chauffeur at	.62½	$ .94
3	Hrs. Tapper at	"	$ 1.88
19	Hrs. Labor at	.45	$ 8.55
	Hrs. Labor at		$
	Hrs. Compressor at		$
	Compensation Ins.		$ .35
	Trucking		$ 1.—
	Builders Use of Water	Before Paving	$ —
	Tap by Hosset		$
			$
			$
			$
			$ 21.71

6 6 1941

Odgen

St. ~~Pl.~~ 34
Ave. No. 32

Name of Owner

G.F. Ferguson

Labor and Mat'l. Report May 23 1941

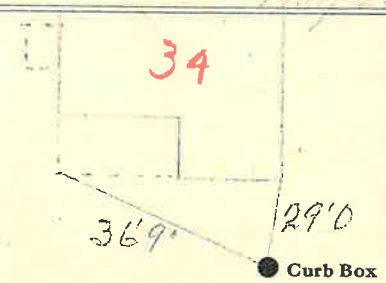

1 Main

Elev. of Main at tap 5

Gate at

Gate at

Curb Box

Tax ID# 302.16-1-13