LABOR AND MATERIALS

_____ Copper / Lead } Connection _____ $_____

_____ Curb { Cock / Valve / T. S. & V. } _____ in. _____ $_____

_____ Service Box Old returned { Short 3½x4½ / Long 4½x5½ / Buff. or Rdway } _____ $_____

_____ Ft. _____ in. { Copper / ~~Galv Iron~~ / ~~Cast Iron~~ } Pipe at _____ $_____

_____ Nipples _____ in. at _____ $_____

_____ Bushings _____ to _____ in. at _____ $_____

_____ Red'g / Inc'g } Couplings _____ to _____ in. at _____ $_____

_____ Union _____ in. at _____ $_____

_____ Meter _____ in. at _____ $_____

_____ Lead Joints at _____ $_____

_____ Leadite Joints at _____ $_____

_____ Hrs. Foreman at _____ $_____

_____ Hrs. Chauffeur at _____ $_____

_____ Hrs. Tapper at _____ $_____

_____ Hrs. Labor at _____ $_____

_____ Hrs. Labor at _____ $_____

_____ Hrs. Compressor at _____ $_____

_____ Compensation Ins. _____ $_____

_____ Trucking _____ $_____

_____ Builders Use of Water _____ $_____

_____ $_____

_____ $_____

_____ $_____

_____ $_____

$_____

St. / ~~Pl.~~ / ~~Ave.~~ No. 11 9

Ogden

Name of Owner

TAX ID # 302.16-5-26

Labor and Mat'l. Report Aug. 21 1939

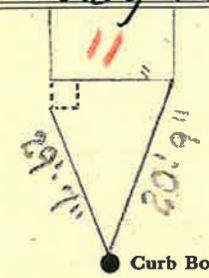

_____ Main

Elev. of Main at tap _____

Gate at ●

● **Gate at**

● **Curb Box**

NEW copper OWNER'S SIDE

JUNE, 1994