LABOR AND MATERIALS

1	Copper / Lead } Connection 3/4		$ 1.35
1	Curb { Cock / Valve / T. S. & V. } 3/4 in.		$ 1.80
1	Service Box / Old returned { Short 3½x4½ / Long 4½x5½ / Buff or Rdway }		$ 1.70
24'	~~22~~ Ft. 3/4 in. { Copper / Galv Iron / Cast Iron } Pipe at 18		$ 3.96
	Nipples in. at		$
	Bushings to in. at		$
	Red'g / Inc'g } Couplings to in. at		$
	Union in. at		$
	Meter in. at		$
	Lead Joints at		$
	Leadite Joints at		$
	Hrs. Foreman at		$
1½	Hrs. Chauffeur at	62½	$ .94
3	Hrs. Tapper at		$ 1.88
19	Hrs. Labor at	.45	$ 8.55
	Hrs. Labor at		$
	Hrs. Compressor at		$
	Compensation Ins.		$ .35
	Trucking		$ 1.—
	Builders Use of Water Before Driving		$
	Taply Hessel		$
			$
			$
			$
			$ 21.53

NEW COPPER INSTALLED
11-27-2002. (KH)

5 3 1941

St. 12
Pl.
Ave. No. 10

Odgen

Name of Owner

Louis Schermerhorn

Labor and Mat'l. Report May 19 1941

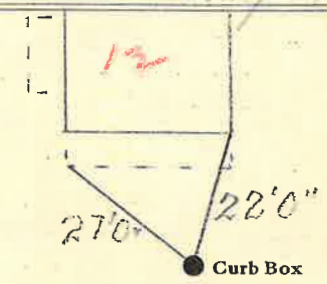

4 Main

Elev. of Main at tap 5

Gate at ● ● Gate at

TAX ID # 302.16-4-5

● Curb Box

NEW COPPER INSTALLED
11-27-2002. (KH)