Labor and Materials

1	Copper ~~Lead~~ Connection	3/4	$ 1.46
1	Curb Cock ~~Valve~~ ~~T. S. & V.~~ in	1/4	$ 1.93
1	Service Box Old returned Short 3½ x 4½ ~~Long 4½ x 5½~~ ~~Buff. or Rdway~~		$ 1.77
26	Ft. in. Copper ~~Galv. Iron~~ Cast Iron Pipe at	3/4	$ 5.72
	Nipples in. at		$
	Bushings to in. at		$
	Red'g Inc'g Conplings to in. at		$
	Union in. at		$
	Meter in. at		$
	Lead Joints at		$
	Leadite Joints at		$
	Hrs. Foreman at		$
2	Hrs. Chauffeur at 62½		$ 1.25
	Hrs. Tapper at		$
6	Hrs. Labor at 45		$ 2.70
	Hrs. Labor at		$
	Hrs. Compressor at		$
	Compensation Ins.		$ 12
	Trucking		$ 1.00
	Builders Use of Water Patch (Sewer)		$ 2.50
			$
			$
			$
	Tap by Pecan		$
			$ 18.45

105-1937

Carl St. ~~Pl.~~ Ave. No. 6

Name of Owner

Daly

Labor and Mat'l. Report Oct 13 1937

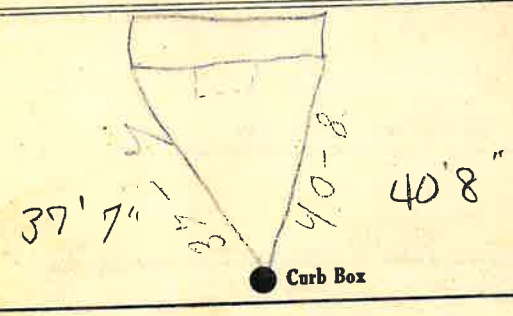

4 Main

Elev. of Main at tap 3½

Gate at

Gate at

Curb Box

New House

TAX ID # 303.13-11-11.