LABOR AND MATERIALS

1	Copper Lead } Connection	$ 1.31
1	Curb { Cock Valve T. S. & V. } 3/4 in.	$ 1.75
1	Service Box Old returned { Short 3½x4½ Long 4½x6½ Buff or Rdway }	$ 1.60
25 Ft.	3/4 in. { Copper Galv Iron Cast Iron } Pipe at 18	$ 4.50
	Nipples in. at	$
	Bushings to in. at	$
	Red'g Inc'g } Couplings to in. at	$
	Union in. at	$
	Meter in. at	$
	Lead Joints at	$
	Leadite Joints at	$
	Hrs. Foreman at	$
1	Hrs. Chauffeur at 62½	$ .63
3/4	Hrs. Tapper at	$ .47
15	Hrs. Labor at 45	$ 6.75
	Hrs. Labor at	$
	Hrs. Compressor at	$
	Compensation Ins.	$ .27
	Trucking	$ 1.21
	Builders Use of Water	$
		$
		$
Tap by Penor		$
		$ 18.28

1 3 8 - 1940

St.
~~Pl.~~
Ave. No. 18

Oneida

Name of Owner

Ball, Robt.

Labor and Mat'l. Report NOV 7 - 1940 19

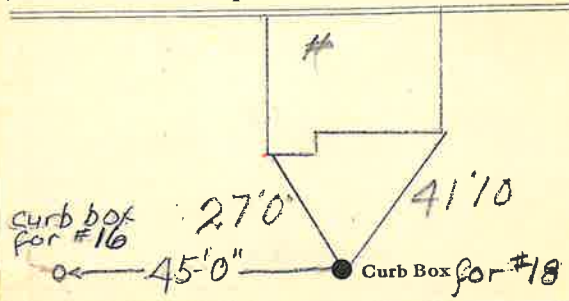

6" Main

Elev. of Main at tap 5'

Gate at ● ● Gate at

TAX ID# 303.13-12-10

● Curb Box

TM