LABOR AND MATERIALS

1	Copper / ~~Lead~~ Connection		$ 1.31
1	Curb { Cock / ~~Valve~~ / ~~T. S. & V.~~ }	3/4 in.	$ 1.75
1	Service Box / ~~Old returned~~ { Short 3½x4½ / ~~Long 4½x5½~~ / Buff or Rdway }		$ 1.60
9	Ft. 3/4 in. { Copper / Galv Iron / Cast Iron } Pipe at 18		$ 1.62
	Nipples ..... in. at		$
	Bushings ..... to ..... in. at		$
	Red'g / Inc'g } Couplings ..... to ..... in. at		$
	Union ..... in. at		$
	Meter ..... in. at		$
	Lead Joints at		$
	Leadite Joints at		$
	Hrs. Foreman at		$
1/2	Hrs. Chauffeur at 62½		$ .31
1/4	Hrs. Tapper at "		$ .16
5 3/4	Hrs. Labor at 45		$ 2.59
	Hrs. Labor at		$
	Hrs. Compressor at		$
	Compensation Ins.		$ .10
	Trucking		$ 1.—
	Builders Use of Water		$
			$
			$
	Tap by Penar		$
			$ 10.44

1 3 4 - 1940

St. ~~Pl.~~ Oneida Ave. No. 19

Name of Owner

Ball, Robt.

Labor and Mat'l. Report NOV 7 - 1940 19

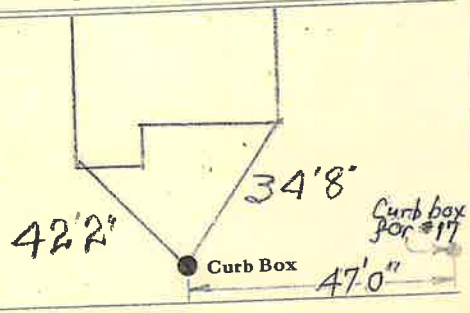

6" Main

Elev. of Main at tap 5'

Gate at ● ● Gate at

TAX ID# 303.13-15-8

● Curb Box

Curb stop in off Position when ON.

BB