LABOR AND MATERIALS

1	Copper / Lead	Connection	$ 1.31
1	Curb { Cock / Valve / T. S. & V. }	3/4 in.	$ 1.75
1	Service Box / Old returned	{ Short 3½x4½ / Long 4½x5½ / Buff or Rdway }	$ 1.60
9	Ft. 3/4 in.	{ Copper / Galv Iron / Cast Iron } Pipe at 16	$ 1.62
	Nipples	in. at	$
	Bushings	to in. at	$
	Red'g / Inc'g	Couplings to in. at	$
	Union	in. at	$
	Meter	in. at	$
	Lead Joints at		$
	Leadite Joints at		$
	Hrs. Foreman at		$
1/2	Hrs. Chauffeur at	62½	$ 31
1/4	Hrs. Tapper at	"	$ 16
5 3/4	Hrs. Labor at	45	$ 2.59
	Hrs. Labor at		$
	Hrs. Compressor at		$
	Compensation Ins.		$ 10
	Trucking		$ 1 —
	Builders Use of Water		$
			$
			$
			$
	Tap by Penor		$
			$ 10.44

1 3 5 - 1940

St. / ~~Pl.~~ Ave. Oneida No. 21

Name of Owner

Ball, Robt.

Labor and Mat'l. Report NOV 7 - 1940 19

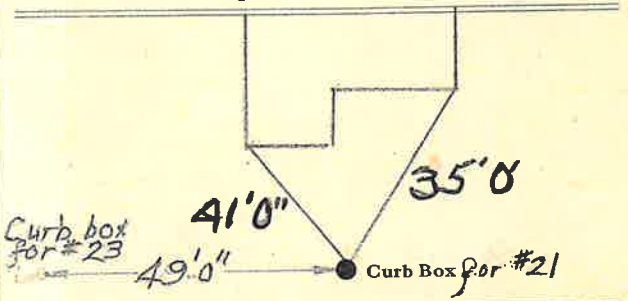

6" Main

Elev. of Main at tap 5'

Gate at ● ● Gate at

TAX ID# 303.13-15-17

● Curb Box

M