LABOR AND MATERIALS

1 Copper / ~~Lead~~ } Connection 3/4" ____ $____

1 Curb } Cock / Valve / T. S. & V. } 3/4 in. ____ $____

1 Service box / ~~Old returned~~ { Short 3½ x 4½ / Long 4½ x 5½ / Buff or Rdway } ____ $____

27 Ft, ~~3/4~~ in. { Copper / ~~G. I.~~ / ~~C. I.~~ } Pipe at ____ $____

____ Nipples ____ in. at ____ $____

____ Bushings ____ to ____ in. at ____ $____

____ Red'g / Inc'g } Coupl'gs ____ to ____ in. at ____ $____

____ Union ____ in. at ____ $____

____ Meter ____ in. at ____ $____

____ Lead Joints at ____ $____

____ Compound Joints at ____ $____

____ Maintenance Foreman ____ $____

____ Hrs. Water Maint. Man—1 at ____ $____

____ Hrs. Water Maint. Man—2 at ____ $____

____ Hrs. Garage Foreman ____ at ____ $____

____ Hrs. Labor— ____ at ____ $____

____ Hrs. Compressor at ____ $____

____ Compensation Ins. at $____ per C ____ $____

____ Trucking ____ $____

____ Pav't Patch ____ $____

Tap by Gifford & Co. 6-15-61 $____

____ $____

____ $____

____ O'head ____ $____

$____

Oneida St. / ~~Pl.~~ / ~~Ave.~~ No. 22

Name of Owner

Jacobs.

Labor and Mat'l. Report June 15 1961.

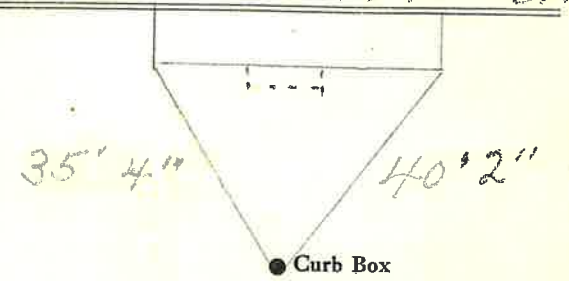

6" C.I. Main

Elev. of Main at tap 4'

Gate at ●

● Gate at

● Curb Box

LSM—5C—3-10-61