Labor and Materials

1	~~Lead~~ Brass Connection 3/4	$
1	Curb Cock 3/4	$
1	Service Box ~~Old returned~~ { Short 3½ x 4½ ~~Long 4½ x 5½~~ Buffalo	$
32'	Ft. 3/4 in. ~~G. I.~~ Cop Pipe at	$
1	Nipples 3/4 in. at	$
	Bushings to in. at	$
	Red'g Coup to in. at	$
1	Inc'g Coup 3/4" to 1" in. at	$
	Union in. at	$
	Meter in. at	$
	Cu. Yds. Br. Stone at	$
	Cu. Yds. Sand at	$
	Bags Cement at	$
	Paving Brick { Mack Red Asphalt } at	$
	Hrs. Foreman at	$
33	Hrs. Common Labor at	$
	Hrs. Mason at	$
	Hrs. at	$
	Hrs. at	$
	Builders' Use of Water	$
	at	$
	at	$
	at	$
	at	$
	Total	$ 27.54

26

Labor and Material Report Sept 21 1925

Pt. Orchard St

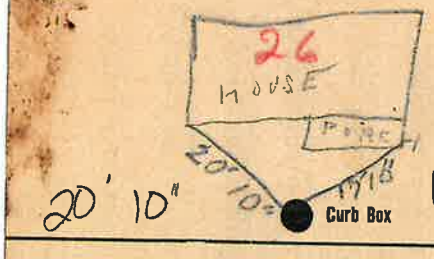

4" Main

Elev. of Main at tap 5'

Gate at ●

● Gate at

● Curb Box

Backwards Curb Stop

TAX ID# 303.17-15-6