LABOR AND MATERIALS

1"	~~Copper~~ / Lead — Connection	$ —
3/4 A	Curb — Cock / Valve / T. S. & V. — in.	$ 3.54
1	Service box — Old returned — Short 3½x4½ / ~~Long 4½x5½~~ / ~~Buff or Rdway~~	$ 4.70
25 Ft. 3/4 in.	~~Copper~~ / ~~G. I.~~ / ~~C. I.~~ — Pipe at 35	$ 8.75
1	Nipples 3 in. at 3/4 Galv	$ —
1	Bushings Adapter to 3/4 in. at	$ .53
1	Red'g / Ine'g — Coupl'gs 1" to 3/4 in. at Galv.	$ —
	Union in. at	$
	Meter in. at	$
	Lead Joints at	$
	Compound Joints at	$
1	Hrs. Water Maint. Man—1 at	$
7.15	Hrs. Water Maint. Man—2 at	$ 17.52
	Hrs. Labor— at	$
20	Hrs. Labor— at 1.02	$ 20.40
4	Hrs. Compressor at 1.50	$ 6.00
	Compensation Ins. at $ 7.66 per C.	$ 1.07
	Trucking	$ 1.50
	Pav't Patch	$ 6.75
1 - 1" x 3/4" Brass Bushing (Main cut)		$ .28
Magnolia		$
		$
	O'head	$
		$ 70.41

To connect old line to house

37.92

Orchard — St. / Pl. / Ave. No. 16

Name of Owner

Magnolia

Labor and Mat'l. Report Mar 22 19 51

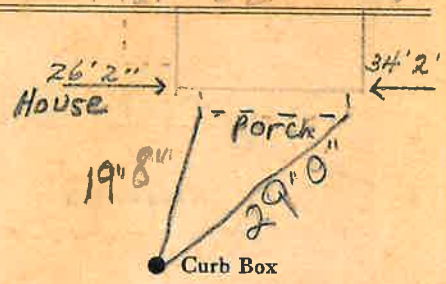

4" Main — Elev. of Main at tap 5'

Gate at ● — ● Gate at

● Curb Box

Tax ID # 303.17-15-2

LSM-5C 10-21-49