LABOR AND MATERIALS

1	Copper / ~~Lead~~ Connection	3/4"	$ 3.08
1	Curb — Cock / ~~Valve~~ / ~~T. S. & V.~~	3/4 in.	$ 3.89
1	Service box — Short 3½ x 4½ / ~~Long 4½ x 5½~~ / ~~Buff or Rdway~~ Old returned		$ 4.32
25	Ft. 3/4 in. — Copper / ~~C. I.~~ / ~~C. I.~~ Pipe at 45		$ 11.25
	Nipples in. at		$
	Bushings to in. at		$
	Red'g / Inc'g Coupl'gs to in. at		$
	Union in. at		$
	Meter in. at		$
	Lead Joints at		$
	Compound Joints at		$
2	Maintenance Foreman	1.937	$ 3.87
11	Hrs. Water Maint. Man—1 at	1.613	$ 17.74
	Hrs. Water Maint. Man—2 at		$
	Hrs. Garage Foreman at		$
2	Hrs. Labor— at	1.481	$ 2.96
20	Hrs. ~~Compressor~~ at Lab.	1.30	$ 26.00
	Compensation Ins. at $ 5.626 per C		$ 2.48
	Trucking		$ 1.50
	Pav't Patch		$ 20.16
	Tap by Gig Ford 5-22-56		$
			$
			$
	O'head		$
			$ 97.65

St. / ~~Pl.~~ Ave. No. 18

Orchard

Name of Owner

O'Hara

Labor and Mat'l. Report May 22 1956

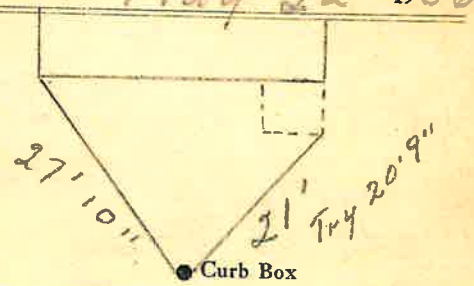

4" Main

Elev. of Main at tap 5½

Gate at ●

● Gate at

● Curb Box

TDX ID # 303.17-15-3

L. M—5C—2-1-54