LABOR AND MATERIALS

1 Copper ~~Iron~~ } Connection 3/4 " $ _____

1 Curb } Cock ~~Valve~~ ~~Pat. S.V.~~ } 3/4 in. (MARK II ORISEAL) $ _____

1 Service box Old returned { Short 3½ x 4½ ~~Long 4½ x 5½~~ ~~Buff or Rdway~~ } _____ $ _____

10 Ft. 3/4 in. { Copper ~~C.I.~~ ~~C.T.~~ } Pipe at _____ $ _____

_____ Nipples _____ in. at _____ $ _____

_____ Bushings _____ to _____ in. at _____ $ _____

_____ { Red'g Inc'g } Coupl'gs _____ to _____ in. at _____ $ _____

_____ Union _____ in. at _____ $ _____

_____ Meter _____ in. at _____ $ _____

_____ Lead Joints at _____ $ _____

_____ Compound Joints at _____ $ _____

_____ Maintenance Foreman _____ $ _____

_____ Hrs. Water Maint. Man—1 at _____ $ _____

_____ Hrs. Water Maint. Man—2 at _____ $ _____

_____ Hrs. Garage Foreman _____ at _____ $ _____

_____ Hrs. Labor— _____ at _____ $ _____

_____ Hrs. Compressor at _____ $ _____

_____ Compensation Ins. at $ _____ per C _____ $ _____

_____ Trucking _____ $ _____

_____ Pav't Patch _____ $ _____

Tap Made By Peck & Co _____ $ _____

_____ $ _____

_____ O'head Oct. 14 1972 $ _____

$ _____

ORMOND St. Pl. Ave. No. 4

Name of Owner

Roger Lynch

Labor and Mat'l. Report Oct. 14 1972

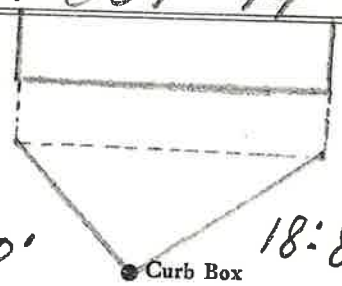

6" Main Elev. of Main at tap 4½'

Gate at ● ● Gate at

THX 10" 309.27-5-2

● Curb Box

LSM—5C—6-1-67