Labor and Materials

Copper Lead { Connection ..... $ .....

Curb { Cock / Valve / T. S. & V. } ..... in ..... $ .....

Service Box { Short 3½ x 4½ / Long 4½ x 5½ / Buff. or Rdway } Old returned ..... $ .....

16 Ft. 3/4 in. { COPPER } Pipe at ..... $ .....

Nipples ..... in. at ..... $ .....

Bushings ..... to ..... in. at ..... $ .....

Red'g / Inc'g { Couplings ..... to ..... in. at ..... $ .....

Union ..... in. at ..... $ .....

Meter ..... in. at ..... $ .....

Lead Joints at ..... $ .....

Leadite Joints at ..... $ .....

Hrs. Foreman at ..... $ .....

Hrs. Chauffeur at ..... $ .....

Hrs. Tapper at ..... $ .....

Hrs. Labor at ..... $ .....

Hrs. Labor at ..... $ .....

Hrs. Compressor at ..... $ .....

Compensation Ins. ..... $ .....

Trucking ..... $ .....

Builders Use of Water ..... $ .....

..... $ .....

..... $ .....

..... $ .....

..... $ .....

$ .....

St. Pl. ~~Ave.~~ Orville No. 35

Name of Owner

TAX ID # 309.27-1-16

Labor and Mat'l. Report 19

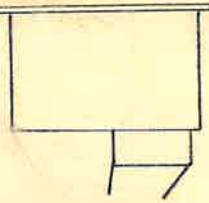

14' 22'10"

Curb Box

..... Main

Elev. of Main at tap ....

Gate at •

• Gate at

Curb Box

NEW. 3/4" COPPER - 1997