LABOR AND MATERIALS

1	Copper Lead — Connection	3/4"	$ 2.29
1	Curb — Cock / Valve / T. S. & V.	3/4" in.	$ 2.70
1	Service box — Old-returned — Short 3½x4½ / Long 4½x5½ / Buff or Rdway		$ 4.25
6	Ft. 3/4 in. — Copper / ~~G. I.~~ / ~~C. I.~~ — Pipe at 35		$ 2.10
	Nipples in. at		$
	Bushings to in. at		$
	Red'g / Inc'g — Coupl'gs to in. at		$
	Union in. at		$
	Meter in. at		$
	Lead Joints at		$
	Compound Joints at		$ 2.97
16	Hrs. Water Maint. Man—1 at	1.02	$ 16.32
15	Hrs. Labor— at	.91	$ 13.65
	Hrs. Labor— at		$
	Hrs. Compressor at		$
	Compensation Ins. at $ per C.		$ .67
	Trucking		$ 1.00
	Pav't Patch		$ 9.45
	Tap by Warsinski		$
			$
			$
	O'head		$
			$ 52.43

Orville — St. ~~Pl.~~ Ave. No. 10

Name of Owner

Jas. F. Dempsey

Labor and Mat'l. Report July 27 1950

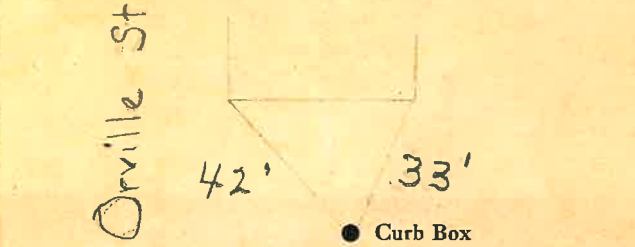

6" Main — Elev. of Main at tap

Gate at — Gate at

Curb Box

TAX ID # 309.27-5-4

LSM-SC 10-21-49