LABOR AND MATERIALS

Copper / Lead } Connection ..... $.....

Curb { Cock / Valve / T. S. & V. } ..... in. ..... $.....

Service Box Old returned { Short 3⅛x4⅛ / Long 4⅛x5⅛ / Buff or Rdway } ..... $.....

..... Ft. 3/4 in. { Copper / ~~Galv Iron~~ / ~~Cast Iron~~ } Pipe at ..... $.....

..... Nipples ..... in. at ..... $.....

..... Bushings ..... to ..... in. at ..... $.....

Red'g / Inc'g } Couplings ..... to ..... in. at ..... $.....

..... Union ..... in. at ..... $.....

..... Meter ..... in. at ..... $.....

..... Lead Joints at ..... $.....

..... Leadite Joints at ..... $.....

..... Hrs. Foreman at ..... $.....

..... Hrs. Chauffeur at ..... $.....

..... Hrs. Tapper at ..... $.....

..... Hrs. Labor at ..... $.....

..... Hrs. Labor at ..... $.....

..... Hrs. Compressor at ..... $.....

..... Compensation Ins. ..... $.....

..... Trucking ..... $.....

..... Builders Use of Water ..... $.....

..... $.....

..... $.....

..... $.....

..... $.....

$.....

Orville St. / Pl. / Ave. No. 42

Name of Owner

Labor and Mat'l. Report SEP 7 - 1939 **19**

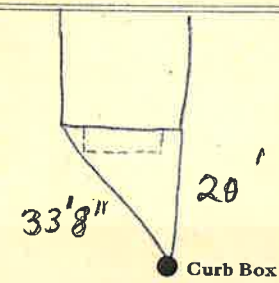

..... Main Elev. of Main at tap .....

Gate at ● ● Gate at

TAX ID# 309.7-11-3

● Curb Box

Renewal Tap - 1981