Labor and Materials

1	Lead Connection ? 4	$
1	Curb Cock 1	$
1	Service Box Old returned {Short 3½ x 4½ / ~~Long 4½ x 5½~~ / Buffalo}	$
23	Ft. in. G. I. Pipe at 1	$
	Nipples in. at	$
1	Bushings to 1 in. at ¾	$
	Red'g Coup to in. at	$
	Inc'g Coup to in. at	$
	Union in. at	$
	Meter in. at	$
	Cu. Yds. Br. Stone at	$
	Cu. Yds. Sand at	$
	Bags Cement at	$
	Paving Brick {Mack / Red / Asphalt} at	$
3	Hrs. Foreman at	$
16	Hrs. Common Labor at	$
	Hrs. Mason at	$
	Hrs. at	$
	Hrs. at	$
	Builders' Use of Water	$
	at	$
	at	$
	at	$
	at	$
	Total	$ 17.69

July 16

Labor and Material Report 19

44 Orville St.

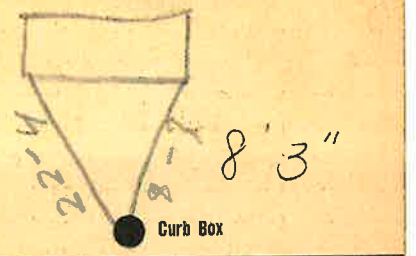

6 Main

Elev. of Main at tap 4

Gate at ● ● Gate at

● Curb Box

TAX ID# 309.7-11-4