## Labor and Materials

| | | |
|---|---|---|
| 1 | Lead Connection 3/4" | $ |
| 1 | Curb Cock 1" | $ |
| 1 | Service Box Old returned { Short 3½ x 4½ / ~~Long 4½ x 5½~~ / Buffalo | $ |
| 18 | Ft. 1" in. G. I. Pipe at | $ |
| | Nipples in. at | $ |
| 1 | Bushings 1" to 1/2" in. at | $ |
| | Red'g Coup to in. at | $ |
| | Inc'g Coup to in. at | $ |
| | Union in. at | $ |
| | Meter in. at | $ |
| | Cu. Yds. Br. Stone at | $ |
| | Cu. Yds. Sand at | $ |
| | Bags Cement at | $ |
| | Paving Brick { Mack / Red / Asphalt } at | $ |
| 3 | Hrs. Foreman at | $ |
| 16 | Hrs. Common Labor at | $ |
| | Hrs. Mason at | $ |
| | Hrs. at | $ |
| | Hrs. at | $ |
| 2.5 | Builders' Use of Water | $ |
| | at | $ |
| | Truck 100 at | $ |
| | at | $ |
| | at | $ |
| | Total | $ 16.91 |

**Labor and Material Report** Sept 3 1929

3/4 tap at 46 Orville st

Old tap dug up

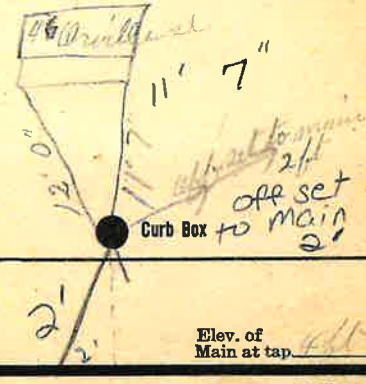


off set to main 2'

6" Main

Elev. of Main at tap 4 ft

Gate at ●

● Gate at

● Curb Box

TAX ID # 309.7-11-5