Labor and Materials

1	Lead Connection 3"	$
1	Curb Cock 1" 4	$
1	Service Box Old returned { Short 3½ x 4½ / ~~[illegible]~~ 5½ / Buffalo	$
11	Ft. 1" in. G. I. Pipe at	$
	Nipples in. at	$
1	Bushings 1 to ½ in. at	$
	Red'g Coup to in. at	$
	Inc'g Coup to in. at	$
	Union in. at	$
	Meter in. at	$
	Cu. Yds. Br. Stone at	$
	Cu. Yds. Sand at	$
	Bags Cement at	$
	Paving Brick { Mack / Red / Asphalt } at	$
3	Hrs. Foreman at	$
10	Hrs. Common Labor at	$
	Hrs. Mason at	$
2	Hrs. [illegible] at	$
	Hrs. at	$
9	Builders' Use of Water	$
	at	$
	Truck 100 at	$
	at	$
	at	$
	Total	$ 13.33

July 2

Labor and Material Report 19

49 Orville St.

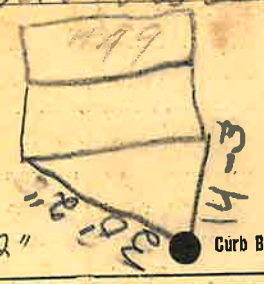

Oct 31-40
Pence

6 Main

Elev. of Main at tap 3½

Gate at ●

● Gate at

● Curb Box

TAX ID # 309.7-9-22