Labor and Materials

1	Lead Connection 3/4	$ 2.69
1	Curb Cock 1	$ 1.76
1	Service Box { ~~Short 3½ x 4½~~ / Long 4½ x 5½ / ~~Buffalo~~ } ~~Old Returned~~	$ 1.44
21	Ft. 1 in. G. I. Pipe at	$ 4.10
	Nipples ..... in. at	$
	Bushings ..... to ..... in. at	$
	Red'g Coup .... to .... in. at	$
	Inc'g Coup .... to .... in. at	$
	Union .... in. at	$
	Meter .... in. at	$
	Cu. Yds. Br. Stone at	$
	Cu. Yds. Sand at	$
	Bags Cement at	$
	Paving Brick { Mack / Red / Asphalt } at	$
2	Hrs. Foreman at	$ 1.25
12	Hrs. Common Labor at	$ 4.88
	Hrs. Mason at	$
	Hrs. at	$
	Hrs. at	$
1	Builders' Use of Water	$ 1.50
1	truck at	$ 1.00
	Comp. Insp. at	$ 1.6
	at	$
	at	$
	Total	$ 18.18

Labor and Material Report

Oct. 1 19 24

56 Orville St. See below

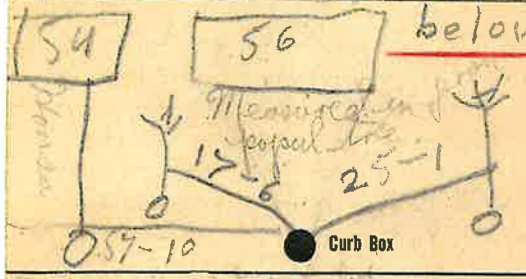

Main

Elev. of Main at tap

Gate at

TAX ID # 309.7-11-9
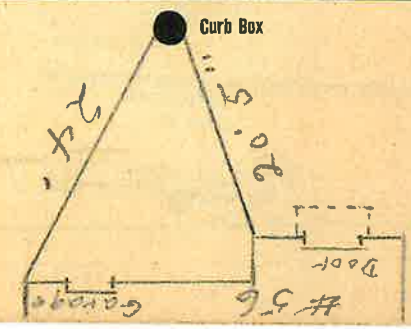
Gate at