Labor and Materials

Copper / Lead } Connection ..... $ .....

Curb { Cock / Valve / T. S. & V. } ..... in ..... $ .....

Service Box Old returned { Short 3½ x 4½ / Long 4½ x 5½ / Buff. or Rdway } ..... $ .....

17 Ft. 1 in. { ~~Copper~~ / Galv Iron / ~~Cast Iron~~ } Pipe at ..... $ .....

Nipples ..... in. at ..... $ .....

Bushings ..... to ..... in. at ..... $ .....

Red'g / Inc'g } Conplings ..... to ..... in. at ..... $ .....

Union ..... in. at ..... $ .....

Meter ..... in. at ..... $ .....

Lead Joints at ..... $ .....

Leadite Joints at ..... $ .....

Hrs. Foreman at ..... $ .....

Hrs, Chauffeur at ..... $ .....

Hrs. Tapper at ..... $ .....

Hrs. Labor at ..... $ .....

Hrs. Labor at ..... $ .....

Hrs. Compressor at ..... $ .....

Compensation Ins. ..... $ .....

Trucking ..... $ .....

Builders Use of Water ..... $ .....

..... $ .....

..... $ .....

..... $ .....

..... $ .....

..... $ .....

Drill ..... St. / ~~Pl.~~ / ~~Ave.~~ No. 6A

Name of Owner

Labor and Mat'l. Report 19

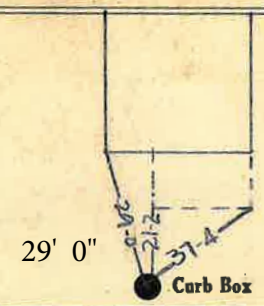

..... Main

Elev. of Main at tap ....

Gate at ●

● Gate at

● Curb Box

TAX ID # 309.7-11-13