Orville St. ~~Pl~~ ~~Ave~~ No. 68

Name of Owner Arthur TAX ID #309.7-11-14

Labor and Mat'l. Report April 22 1946

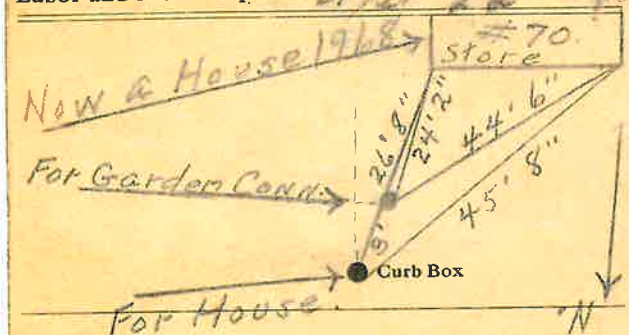

6 Main Elev. of Main at tap 5½

Gate at ● ● Gate at

HOUSE HAS SEPTIC TANK

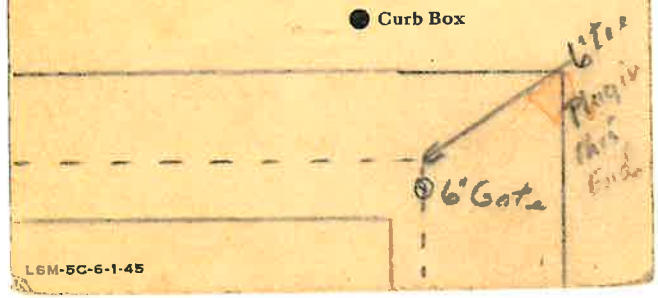

L6M-5C-6-1-45

LABOR AND MATERIALS

1	Copper ~~Lead~~ Connection	3/4	$ 1.78
1	Curb { Clock Valve T. S. & V. }	3/4 in.	$ 2.61
1	Service box Old returned { Short 3½X4½ Long 4½X5½ Buff or Rdway }		$ 1.82
36	Ft. 3/4 in. { Copper Galv. Iron Cast Iron } Pipe at 23		$ 8.28
	Nipples in. at		$
	Bushings to in. at		$
	Red'g Inc'g } Couplings to in. at		$
	Union in. at		$
	Meter in. at		$
	Lead Joints at		$
	Compound Joints at		$
2	Hrs. ~~Foreman~~ at Wm	84	$ 1.68
5	Hrs. Chauffeur at	75	$ 3.75
6	Hrs. Tapper at		$ 4.50
10	Hrs. Labor at	65	$ 6.50
	Hrs. Labor at		$
2	Hrs. Compressor at	87½	$ 1.75
	Compensation Ins.		$ .45
	Trucking		$ 1.00
	Builders Use of Water	2	$ 5.00
	Tap by Mayerson		$
			$
			$
			$
	¾ Copper Pipe		$ 39.12

6" Tee
6" Gate