Labor and Materials

1	Lead Connection	3/4	$
1	Curb Cock	1	$
1	Service Box Old returned	Short 3½ x 4' / Long 4½ x 5½ / Buffalo	$
1	14 Ft. ... in. G. I. Pipe at 1		$
	Nipples ... in. at		$
1	Bushings 1 to 1/2 in. at		$
	Red'g Coup. ... to ... in. at		$
	Inc'g Coup ... to ... in. at		$
	Union ... in. at		$
	Meter ... in. at		$
	Cu. Yds. Br. Stone at		$
	Cu. Yds. Sand at		$
	Bags Cement at		$
	Paving Brick (Mack / Red / Asphalt) at		$
3	Hrs. Foreman at		$
9	Hrs. Common Labor at		$
	Hrs. Mason at		$
	Hrs.	at	$
	Hrs.	at	$
9.6	Builders' Use of Water		$
		at	$
3	Truck 1.00	at	$
		at	$
		at	$
	Total		$ 13.37

Labor and Material Report July 30 19

12 Orville St.

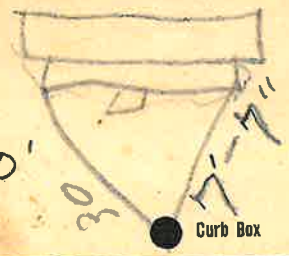

TAX ID # 309.27-3-6

4 Main

Elev. of Main at tap 6' 2"

Gate at ● ● Gate at

● Curb Box

This House Razed, shut off at curb 12-4-43.