Labor and Materials

1	Lead Connection 3/4	$
1	Curb Cock 1"	$
1	Service Box Old returned { ~~Short~~ 3½ x 4½ / Long 4½ x 5½ / ~~Buffalo~~	$
12	Ft. 1" in. G. I. Pipe at	$
1	Nipples 3/4 in. at	$
	Bushings in. at	$
	Red'g Coup to in. at	$
	Inc'g Coup to in. at	$
	Union in. at	$
	Meter in. at	$
	Cu. Yds. Br. Stone at	$
	Cu. Yds. Sand at	$
	Bags Cement at	$
	Pav. Brick { Mack / Red / Asphalt } at	$
3	Hrs. Foreman at	$
12	Hrs. Com. Labor at	$
	Hrs. Mason at	$
	Hrs. at	$
	Hrs. at	$
20	Builders' Use of Water	$
	at	$
	Truck 1.00 at	$
	at	$
	at	$
	Total	$ 14.66

Labor and Material Report

Week Sept 8 to Sept 15 1923

3/4 Tap at ~~85~~ 41-47 Park St

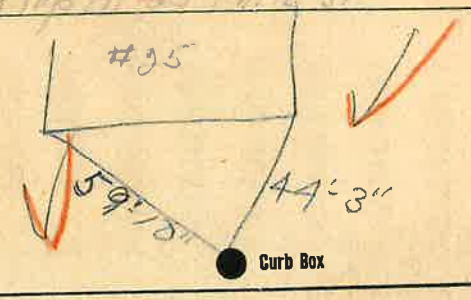

6" Main

Elev. of Main at tap 4½

Gate at

Gate at

Curb Box